

Submittal Comments Sheet

Project: Evermore / Boathouse
PSW Project No.: 931A
Reference: [06 2200 Wave Fin Shop Drawings](#)
Submitted By: Wendell Kinzler



SUBMITTAL REVIEW

REVIEWED BY : W. KINZLER

DATE : [12.13.22](#)

<input type="checkbox"/>	NO EXCEPTION TAKEN	<input type="checkbox"/>	REVISE AND RESUBMIT
<input checked="" type="checkbox"/>	FURNISH AS CORRECTED	<input type="checkbox"/>	REJECTED
<input type="checkbox"/>	SUBMIT SPECIFIC ITEM	<input type="checkbox"/>	FOR RECORD ONLY

THIS REVIEW IS ONLY FOR GENERAL CONFORMANCE WITH THE DESIGN CONCEPT OF THE PROJECT AND GENERAL COMPLIANCE WITH THE INFORMATION GIVEN IN THE CONSTRUCTION DOCUMENTS. CORRECTIONS OR COMMENTS MADE ON THE SHOP DRAWINGS DURING THIS REVIEW DO NOT RELIEVE THE CONTRACTOR FROM COMPLIANCE WITH THE REQUIREMENTS OF THE PLANS AND SPECIFICATIONS. REVIEW OF A SPECIFIC ITEM SHALL NOT INCLUDE AN EVALUATION OF AN ASSEMBLY OF WHICH THE ITEM IS A COMPONENT.

THE CONTRACTOR IS RESPONSIBLE FOR : DIMENSIONS TO BE CONFIRMED AND CORRELATED AT THE JOB SITE ; INFORMATION THAT PERTAINS SOLELY TO THE FABRICATION PROCESS OR TO THE MEANS, METHODS, TECHNIQUES, SEQUENCES, AND PROCEDURES OF CONSTRUCTION ; COORDINATION OF THE WORK WITH THAT OF ALL OTHER TRADES ; AND FOR PERFORMING ALL WORK IN A SAFE AND SATISFACTORY MANNER

Comments:

1. Refer to architects comments on shop drawings and attached sheet, A602.



Date: 11/21/2022

- LETTER OF TRANSMITTAL -

To: Wendell Kinzler, AIA
POLK STANLEY WILCOX
ARCHITECTS, LTD. INC
801 S Spring St
Little Rock, AR 72201

Re: Boathouse - Evermore Orlando Resort
MEC JOB #:52401
FILE:

DESCRIPTION: 06 22 00 - Wave Fin Shop Drawings

Transmitted:

☐ For Your Use

☐ As Requested

☐ For Signature

☒ For Review and Comment

☐ Other: _____




<input type="checkbox"/> APPROVED AS SUBMITTED	<input type="checkbox"/> RESUBMIT FOR APPROVAL
<input type="checkbox"/> APPROVED AS NOTED	<input type="checkbox"/> RESUBMIT FOR REVIEW
<input type="checkbox"/> NOT APPROVED	<input type="checkbox"/> NO EXCEPTIONS TAKEN
<input checked="" type="checkbox"/> REVIEWED	

Submittal review is based upon compliance with the design concept of the project and information in the Contract Documents. The Contractor is responsible to confirm dimensions of the job site for the fabrication process, techniques of construction and coordination of the work with all trades. Shop Drawing errors do not relieve the Contractor of complying with the Contract Documents, applicable codes or specifications.

DATE: 11/21/2022 BY: Eric Crabtree

Eric Crabtree
Associate Project Manager
ECrabtree@MECFlorida.com

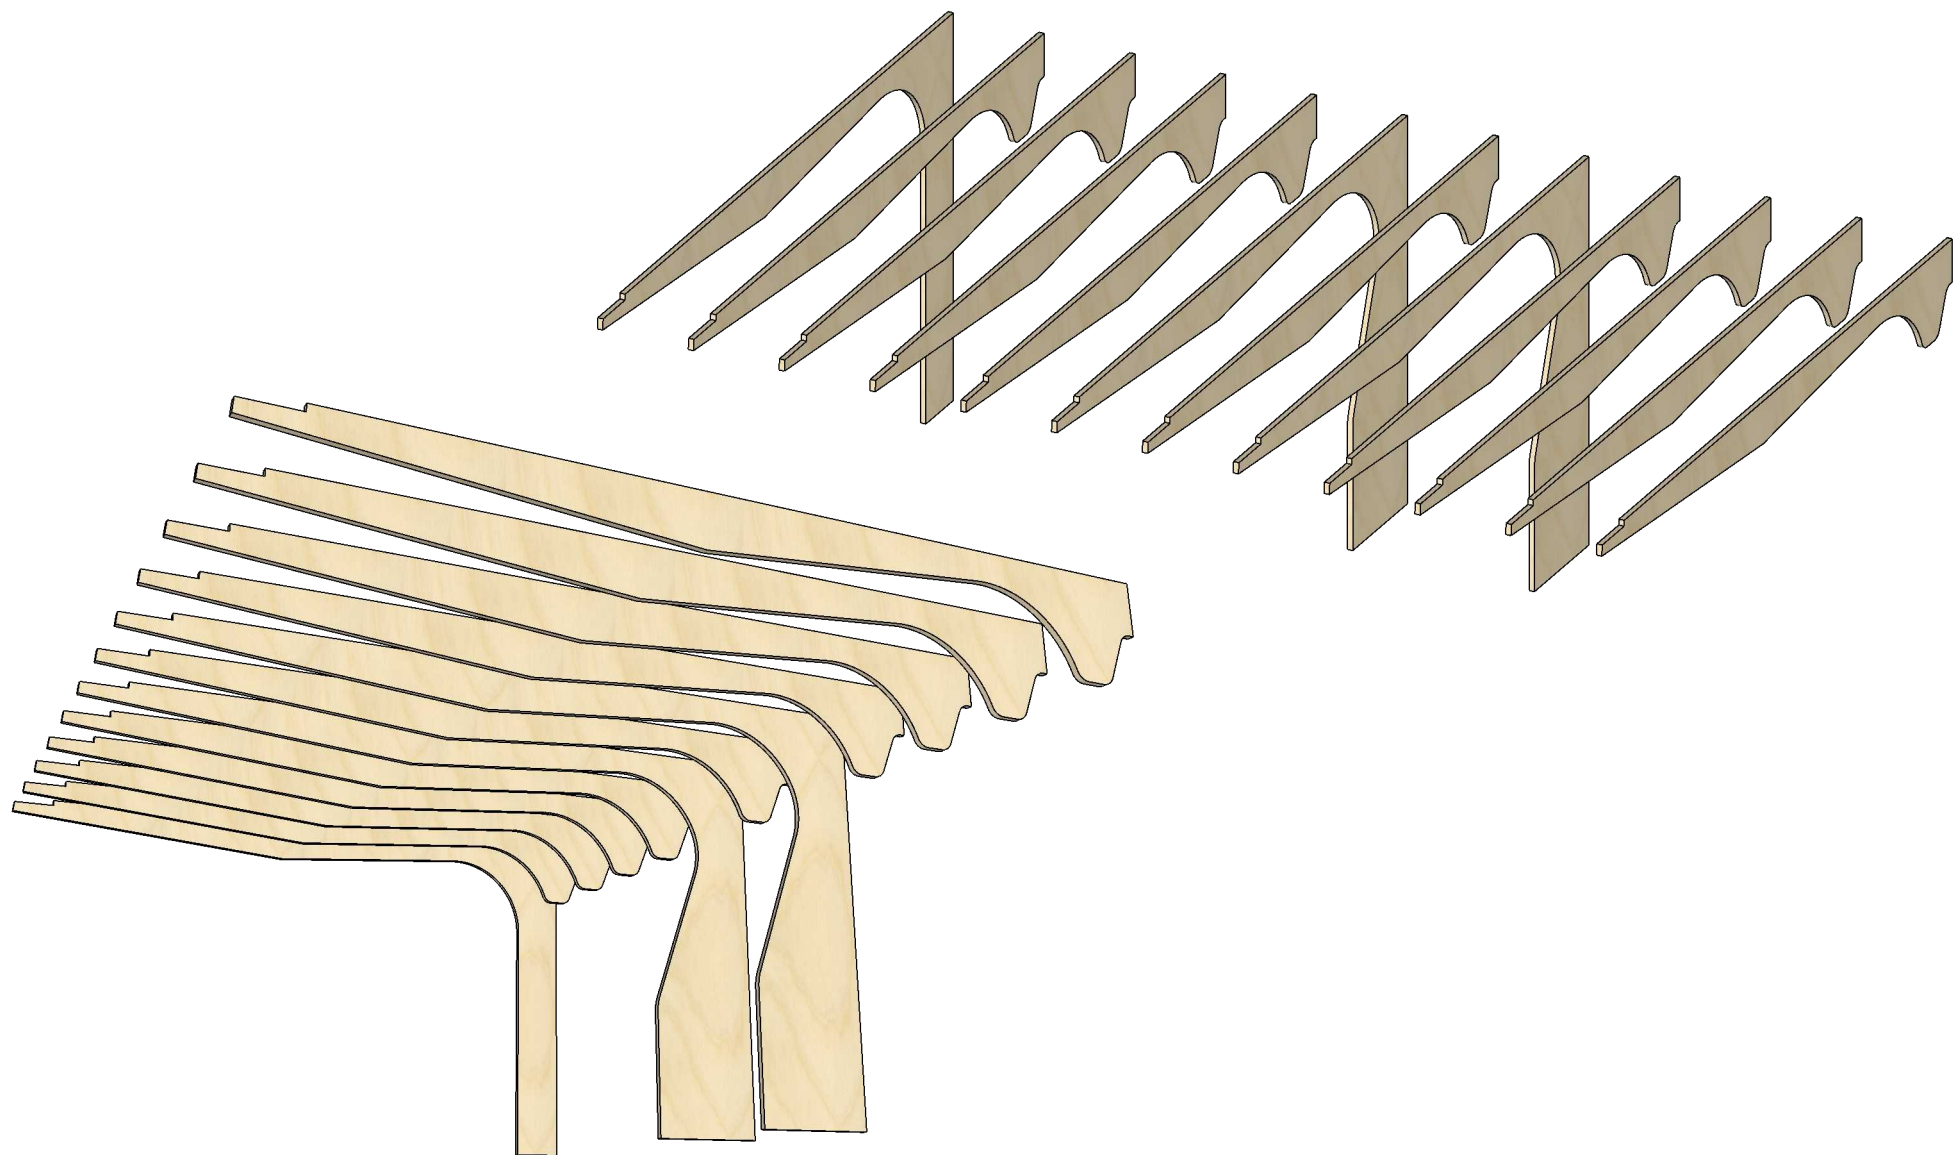

HEIRLOOM DESIGN GROUP




FELIPE CORREA


2770 Apopka Blvd
Apopka, FL 32703
(321)947-2459


felipeco.hdg@gmail.com

EVERMORE - BOATHOUSE
3D WAVE

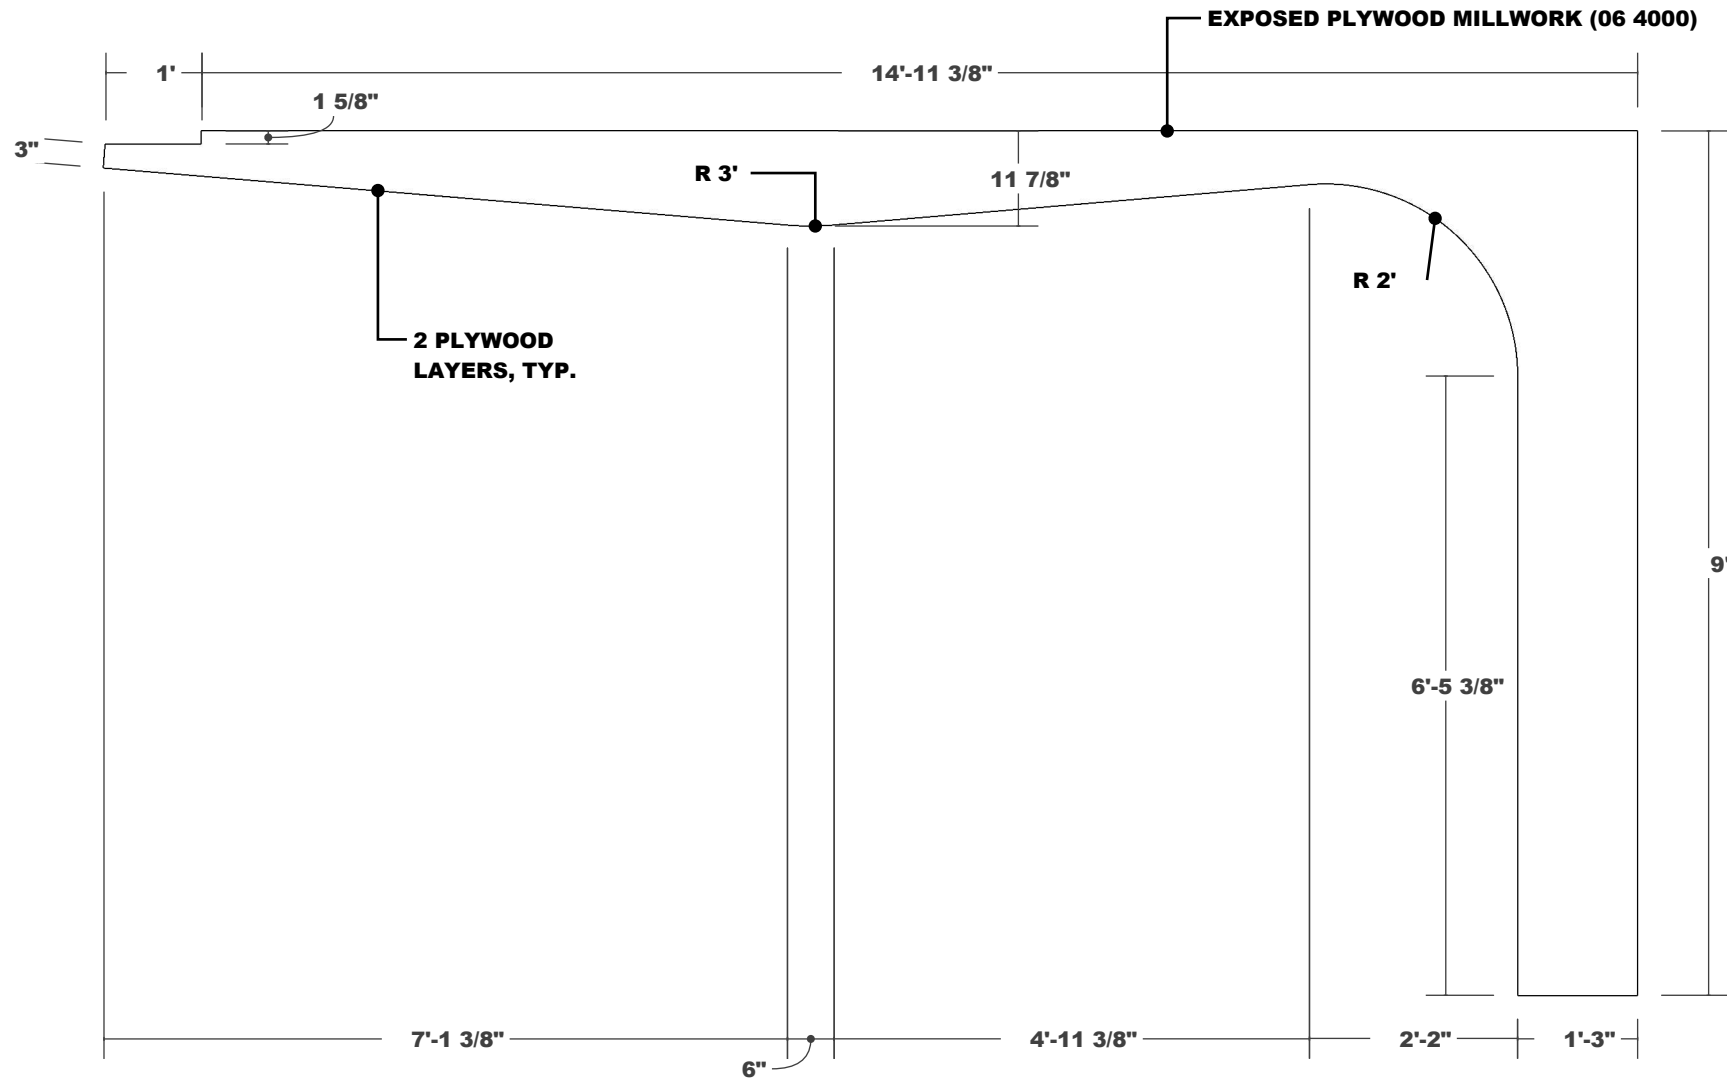

GC TO VERIFY
HEIGHT OF
LOWEST DUCT
IN THIS SPACE

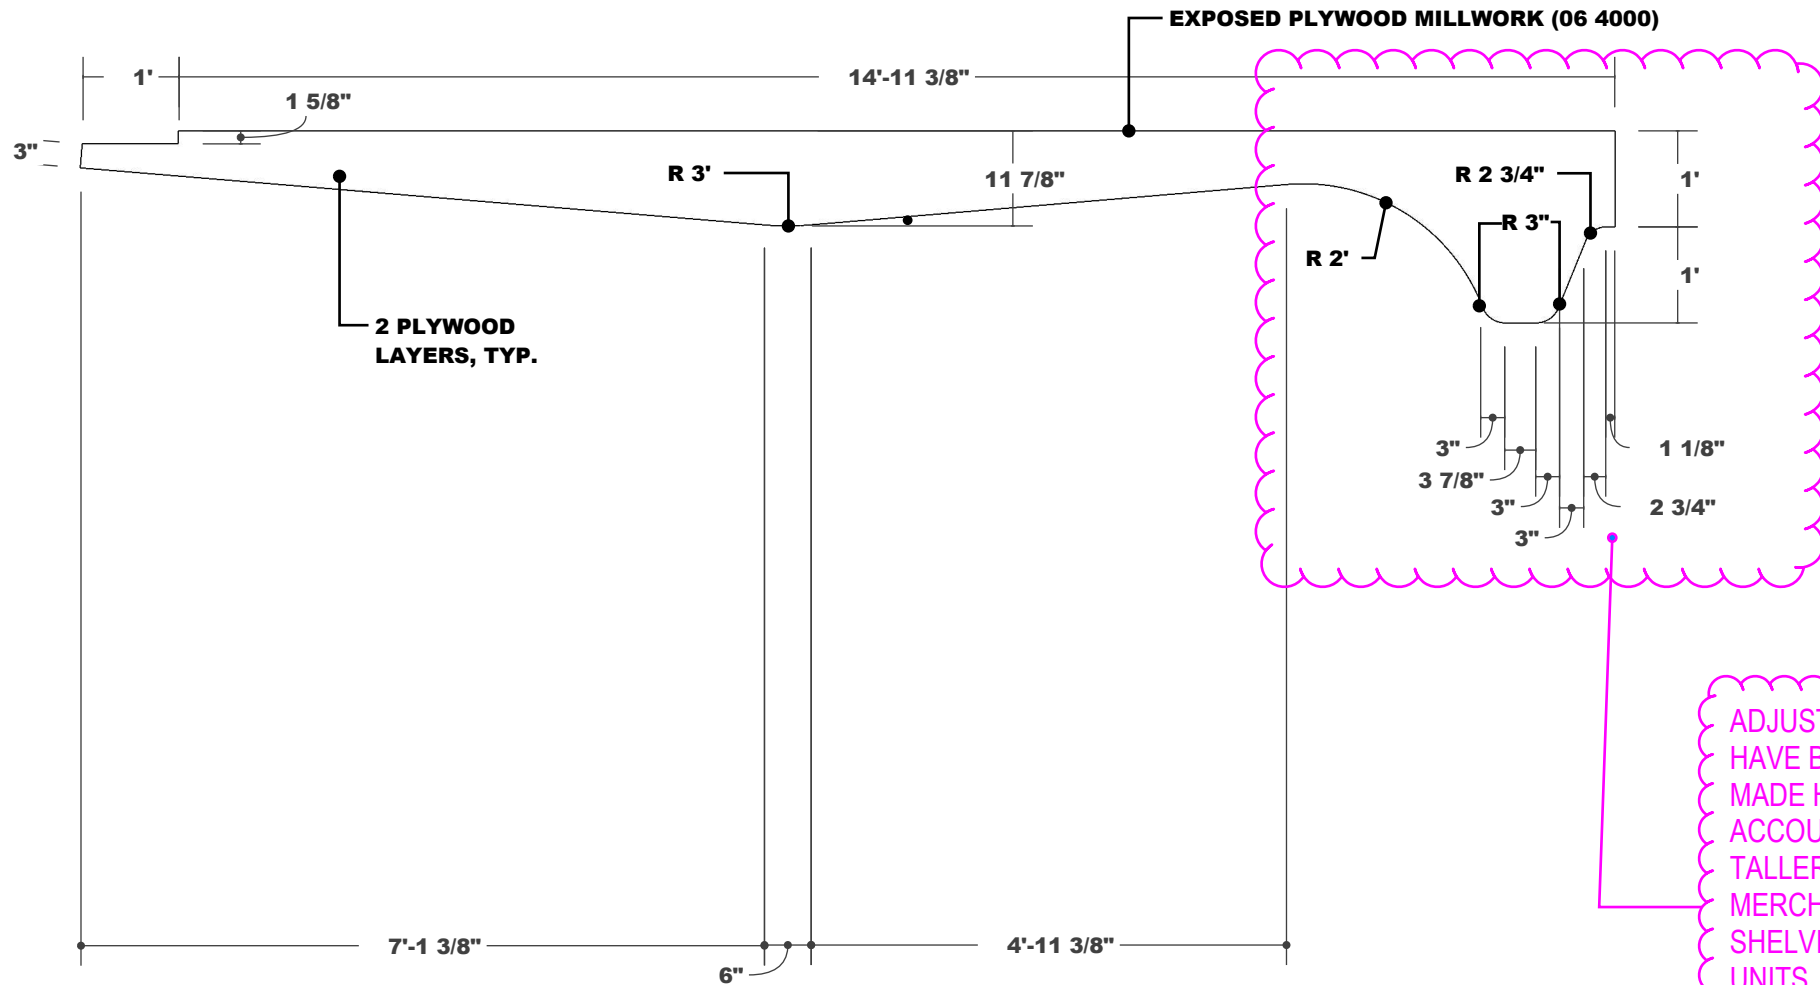

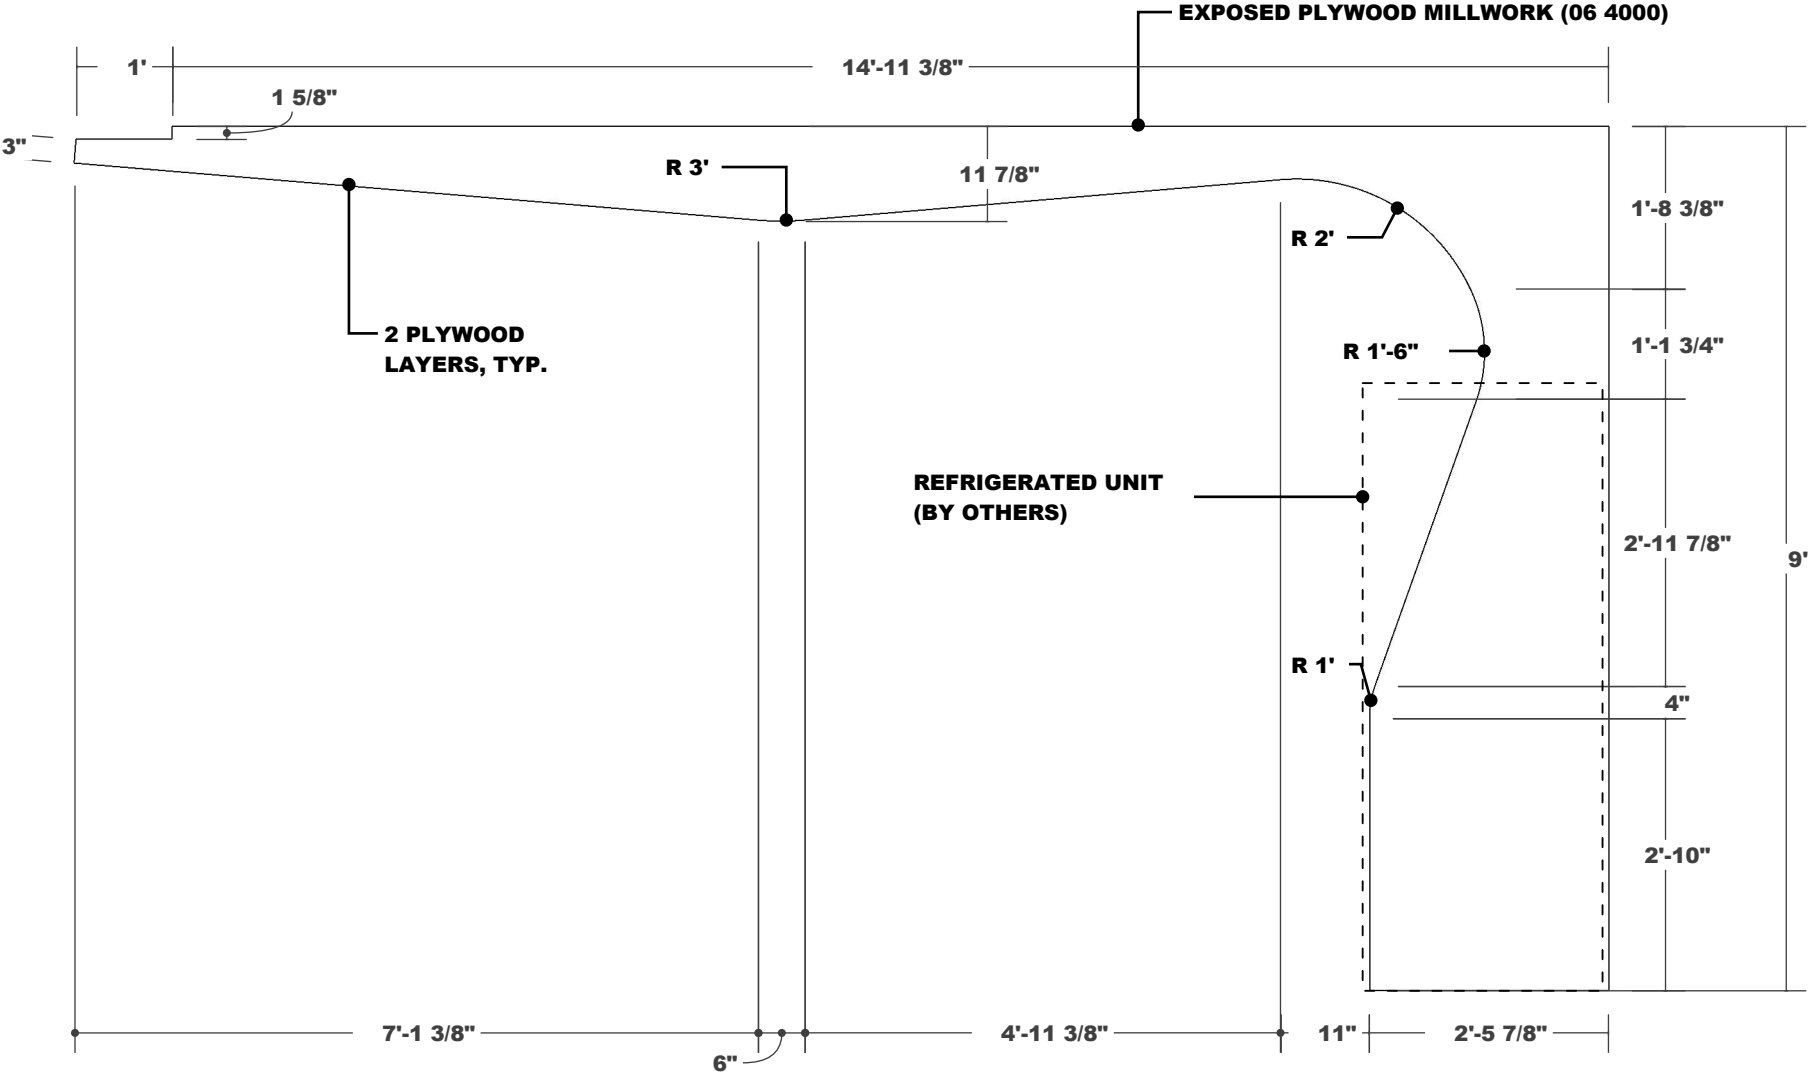

11 | 004 OFFICE D
3/8" = 1'-0"

10 | 004 OFFICE C
3/8" = 1'-0"

9 | 004 OFFICE B
3/8" = 1'-0"

8 | 004 OFFICE A
3/8" = 1'-0"

7 | ENLARGED PLAN - 004 OFFICE
1/4" = 1'-0"

6 | 003 CORRIDOR

4 | WAVE FIN TYPE C

3 | WAVE FIN TYPE B

2 | WAVE FIN TYPE A

1 | PLYWOOD FINS 3D VIEW

5 | PLYWOOD FINS 3D VIEW 2

FOR CONSTRUCTION SET

PSW Job Number:
031A

EVERMORE -
BOATHOUSE

Orlando, FL

Issue Date: 10.01.21

FOR CONSTRUCTION SET

REVISIONS	
DATE	DESCRIPTION
10.27.21	PRE-BID ADDENDUM #1

Contents:

ENLARGED PLANS
AND INTERIOR
ELEVATIONS